

APPLICATION FOR PERMIT  
BAYFIELD COUNTY, WISCONSIN

SUBMIT COMPLETED ORIGINAL  
APPLICATION, TAX STATEMENT  
AND FEE TO:

Bayfield County Zoning Department  
P.O. Box 58  
Washburn, WI 54891  
(715) 373-6138

**B** E F I E  
MAR 26 2009  
Bayfield Co. Zoning Dept.

\$125

Application No.: 09-0135  
Date: \_\_\_\_\_  
Zoning District: RRB  
Amount Paid: \$125 4-1-09  
mg

INSTRUCTIONS: No permits will be issued until all fees are paid.  
Checks are made payable to: Bayfield County Zoning Department.  
DO NOT START CONSTRUCTION UNTIL ALL PERMITS HAVE BEEN ISSUED TO APPLICANT.  
Changes in plans must be approved by the Zoning Department.

LAND USE  SANITARY  PRIVY  CONDITIONAL USE  SPECIAL USE  B.O.A.  OTHER \_\_\_\_\_  
Legal Description S.W. 1/4 of SE 1/4 of Section S17 Township T43N North Range R21W West Town of Cable  
Gov't Lot 2 Block \_\_\_\_\_ Subdivision V.R. P. 3 C&SM # 14443 Acreage 4.55  
Volume 1006 Page 267 of Deeds Parcel I.D. # 04-012-2-43-07-17-4 03-000-65100  
Property Owner Randolph L. LaRue Confession LaRue Construction 715 271 1507  
Address of Property South Riverside Rd. Plumber Rassmussen  
Cable, WI 54821 Authorized Agent Sam LaRue Jr (Phone) 715 271 1507  
Telephone 382 5411 (Home) 226 1091 Cell 715 271 1507 (Work) 715 271 1507  
Written Authorization Attached: Yes  No

is your structure in a Shoreland Zone? Yes  No  If yes, Distance from Shoreline: greater than 75'  75' to 40'  less than 40'

Structure: New \_\_\_\_\_ Addition  Existing  Basement: Yes  No \_\_\_\_\_ Number of Stories one  
Estimated Cost of Construction 20,000.00 Square Footage 1270 Sanitary: New  Existing \_\_\_\_\_ Privy \_\_\_\_\_ City \_\_\_\_\_  
USE:  
 \* Residence or Principal Structure (# of bedrooms) 3 1510  Mobile Home (manufactured date) \_\_\_\_\_  
Residence sq. ft. 1270 Deck SF 240 SF  Commercial Principal Building \_\_\_\_\_  
 \* Residence w/deck-porch (# of bedrooms) \_\_\_\_\_  Commercial Principal Building Addition (explain) \_\_\_\_\_  
Residence sq. ft. \_\_\_\_\_ Porch sq. ft. \_\_\_\_\_  Commercial Accessory Building (explain) \_\_\_\_\_  
Deck sq. ft. \_\_\_\_\_ Deck(2) sq. ft. \_\_\_\_\_  Commercial Accessory Building Addition (explain) \_\_\_\_\_  
 \* Residence w/attached garage (# of bedrooms) \_\_\_\_\_  Commercial Accessory Building Addition (explain) \_\_\_\_\_  
Residence sq. ft. \_\_\_\_\_ Garage sq. ft. \_\_\_\_\_  Commercial Other (explain) \_\_\_\_\_  
 Residential Addition / Alteration (explain) \_\_\_\_\_  Special/Conditional Use (explain) \_\_\_\_\_  
 Residential Accessory Building (explain) \_\_\_\_\_  External Improvements to Principal Building (explain) \_\_\_\_\_  
 Residential Accessory Building Addition (explain) \_\_\_\_\_  External Improvements to Accessory Building (explain) \_\_\_\_\_  
 Residential Other (explain) \_\_\_\_\_

FAILURE TO OBTAIN A PERMIT OF STARTING CONSTRUCTION WITHOUT A PERMIT WILL RESULT IN PENALTIES

I (we) declare that this application (including any accompanying information) has been examined by me (us) and to the best of my (our) knowledge and belief it is true, correct and complete. I (we) acknowledge that I (we) am (are) responsible for the detail and accuracy of all information I (we) am (are) providing and that it will be relied upon by Bayfield County in determining whether to issue a permit. I (we) further accept liability which may be a result of Bayfield County relying on this information I (we) am (are) providing in or with this application. I (we) consent to county officials' charged with administering county ordinances to have access to the above described property at any reasonable time for the purpose of inspection.

Owner or Authorized Agent (Signature) Randolph L. LaRue Date 11/05/08  
Address to send permit 17421 95th Ave ATTACH \_\_\_\_\_  
Chippewa Falls WI 54729 Copy of Tax Statement   
If you previously purchased the property Attach a Copy of Recorded Deed \_\_\_\_\_

\* See Notice on Back


APPLICANT - PLEASE COMPLETE REVERSE SIDE

Permit Issued: \_\_\_\_\_ State Sanitary Number 09-185 Date 5/13/09  
Date 5-14-09 Permit Number 09-0135 Permit Denied (Date) \_\_\_\_\_  
Reason for Denial: \_\_\_\_\_  
Inspection Record: Meets all setbacks Property lines per code & agent's representations By M. Fuitak Date of Inspection 3-30-09  
Mitigation Plan Required: Yes  No  Variance (B.O.A.) # \_\_\_\_\_  
Condition: \_\_\_\_\_  
Signed Michael Fuitak Inspector Date of Approval 3-30-09  
Rec'd for Issuance \_\_\_\_\_  
MAY 14 2009  
Secretarial Staff



1" = 100'

Lot Line

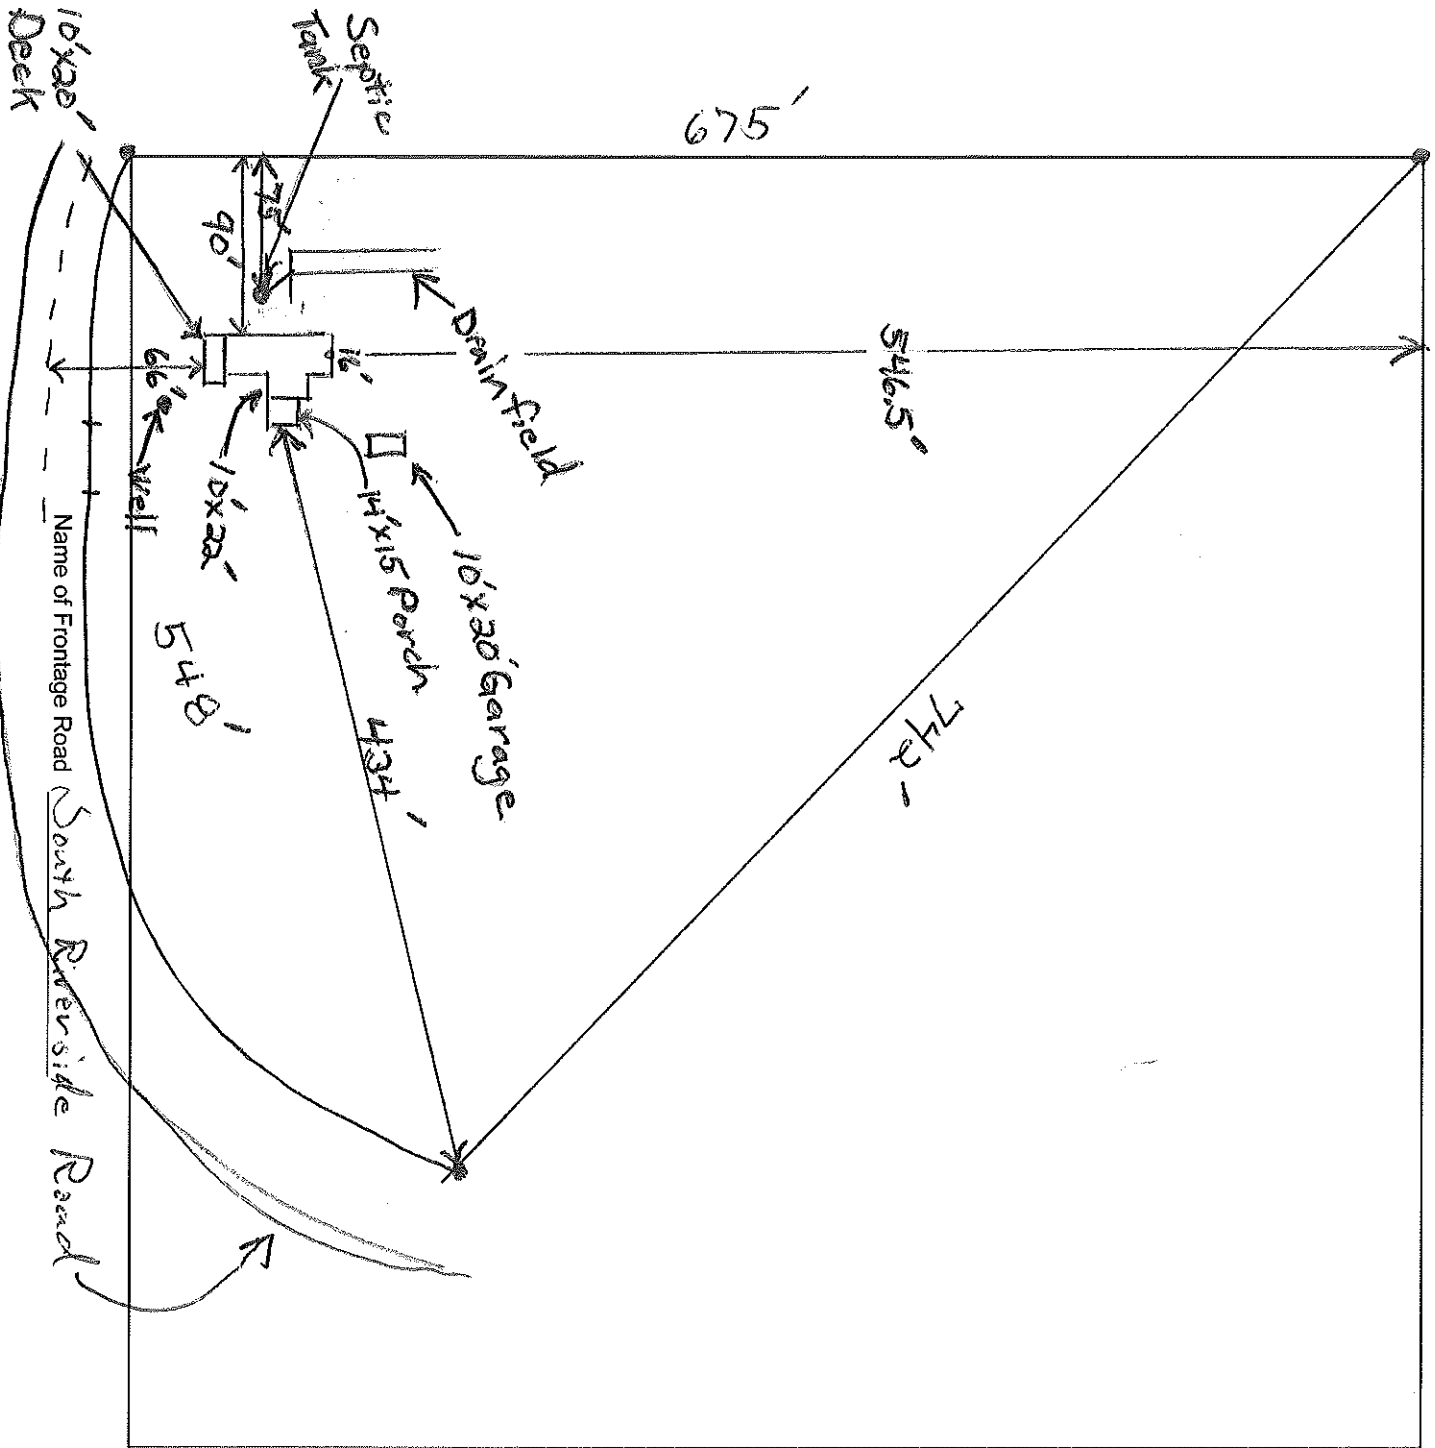

- \* Name the frontage road and use as a guideline, fill in the lot dimensions and indicate North (N).
- \* Show the location, size and dimensions of the structure - (include any deck(s), porch or garage)
- \* Show the location of the well, septic-tank and drain-field.
- \* Show the location of any lake, river, stream or pond if applicable. None
- \* Show the approximate location of other existing structures.
- \* Show the approximate location of any wetlands or slopes over 20 percent.
- \* Show dimensions in feet on the following:
  - \* Building to all lot lines
  - \* Building to centerline of road 66'
  - \* Building to lake, river, stream or pond
  - \* Septic tank to closest lot line 75'
  - \* Septic tank to building 50'
  - \* Septic tank to well 50'
  - \* Septic tank to lake, river, stream or pond
  - \* ~~Privy to closest lot line~~

**IMPORTANT**  
 DETAILED PLOT PLAN  
 IS NECESSARY, FOLLOW  
 STEPS 1-7 (a-o) COMPLETELY.

- ~~Privy to building~~
- ~~Privy to lake, river, stream or pond~~
- ~~Drain field to closest lot line~~ 75'
- ~~Drain field to building~~ 35'
- ~~Drain field to well~~ 25'
- ~~Drain field to lake, river, stream or pond~~
- ~~Well to building~~ 20'

\*NOTICE: All Land Use Permits Expire One (1) Year From The Date Issued.

For The Construction Of New One & Two Family Dwellings: ALL Municipalities Are Required To Enforce The Uniform Dwelling Code. You Must Contact Your Town Chairman / Clerk For More Information.

The local town, village, city, state or federal agencies may also require permits.

Stake or mark proposed location(s) of new building, septic, drain field, privy, and well. Inspector will not make an inspection until location(s) are staked or marked.

*Lot is Staked*