

SUBMIT COMPLETED ORIGINAL APPLICATION, TAX STATEMENT AND FEE TO:  
 Bayfield County Zoning Department  
 P.O. Box 58  
 Washburn, WI 54891  
 (715) 373-6138

APPLICATION FOR PERMIT  
 BAYFIELD COUNTY, WISCONSIN

RECEIVED  
 JUN 02 2008  
 Bayfield Co. Zoning Dept.

Application No: 08-0232  
 Date: \_\_\_\_\_  
 Zoning District: RRB/CBS  
 Amount Paid: 6-12-08  
\$150 CK/mj

INSTRUCTIONS: No permits will be issued until all fees are paid. Checks are made payable to: Bayfield County Zoning Department. DO NOT START CONSTRUCTION UNTIL ALL PERMITS HAVE BEEN ISSUED TO APPLICANT. Changes in plans must be approved by the Zoning Department.

JUN 12 2008  
 Bayfield Co. Zoning Dept.

LAND USE  SANITARY  PRIVY  SPECIAL USE  B.O.A.  OTHER  
 Legal Description: 1/4 of Section 14 of Township 51 North, Range 7 West, Town of Clover (H)  
 Gov't Lot 6 Lot 4 Block \_\_\_\_\_ Subdivision \_\_\_\_\_ CSM # 1034 Acreage 0.910  
 Volume 983 Page 48 of Deeds Parcel I.D. # 04-04-a-51-01-26-4 05-006-3000  
 (Use Tax Statement for Legal Description)

Property Owner: PATRICK R MORIARITY Contractor: SAE (Phone) \_\_\_\_\_  
 Address of Property: 89455 BARK POINT RD Plumber \_\_\_\_\_  
CLOVER WI 54844 Authorized Agent \_\_\_\_\_ (Phone) \_\_\_\_\_

Telephone: 651-257-5566 (Home) 651-428-2610 (Work)  
 Is your structure in a Shoreland Zone? Yes  No  If yes, \_\_\_\_\_  
 Written Authorization Attached: Yes  No

Structure: New \_\_\_\_\_ Addition  Existing \_\_\_\_\_  
 Estimated Cost of Construction: 8,000 ± Square Footage 70 ± Sanitary: New \_\_\_\_\_ Existing  Privy \_\_\_\_\_ City \_\_\_\_\_  
 USE: \_\_\_\_\_

- \* Residence or Principal Structure (# of bedrooms) \_\_\_\_\_  
 Residence sq. ft. \_\_\_\_\_
- \* Residence w/deck-porch (# of bedrooms) \_\_\_\_\_  
 Residence sq. ft. \_\_\_\_\_ Porch sq. ft. \_\_\_\_\_
- Residence w/attached garage (# of bedrooms) \_\_\_\_\_  
 Deck sq. ft. \_\_\_\_\_ Deck(2) sq. ft. \_\_\_\_\_
- Residence sq. ft. \_\_\_\_\_ Garage sq. ft. \_\_\_\_\_
- Residential Addition / Alteration (explain) \_\_\_\_\_
- Residential Accessory Building (explain) \_\_\_\_\_
- Residential Accessory Building Addition (explain) \_\_\_\_\_
- Residential Other (explain) ADD DECK 2ND FLR.


FAILURE TO OBTAIN A PERMIT OR STARTING CONSTRUCTION WITHOUT A PERMIT WILL RESULT IN PENALTIES  
 I (we) declare that this application (including any accompanying information) has been examined by me (us) and to the best of my (our) knowledge and belief it is true, correct and complete. I (we) acknowledge that I (we) am (are) responsible for the detail and accuracy of all information I (we) am (are) providing and that it will be relied upon by Bayfield County in determining whether to issue a permit. I (we) further accept liability which may be a result of Bayfield County relying on this information I (we) am (are) providing in or with this application. I (we) consent to county officials charged with administering county ordinances to have access to the above described property at any reasonable time for the purpose of inspection.  
 Owner or Authorized Agent (Signature): Patrick R Moriarity Date: 5-28-08  
 Address to send permit: 16157 Quiet Valley Rd Lindstrom MN 55045 ATTACH  
 Copy of Tax Statement  
 If you previously purchased the property Attach a Copy of Recorded Deed

\* See Notice on Back APPLICANT - PLEASE COMPLETE REVERSE SIDE

Permit Issued: \_\_\_\_\_ State Sanitary Number 327231 Date 1999  
 Date: 6/12/08 Permit Number 08-0232 Permit Denied (Date) \_\_\_\_\_  
 Reason for Denial: \_\_\_\_\_  
 Inspection Record: AS BUILT SETBACKS & CONDITIONS AS REPRESENTED BY OWNER BREAKS TO BE CODE COMPLIANT & L.O. PERMIT MAY BE ISSUED. By DOC Date of Inspection 6-4-08  
 Mitigation Plan Required: Yes  No  Variance (B.O.A.) # \_\_\_\_\_  
 Condition: \_\_\_\_\_  
 Signed: [Signature] Inspector \_\_\_\_\_  
 Date of Approval: 6-11-08  
 Bayfield Co. Zoning Dept.  
 JUN 12 2008

ALL EXISTING STRUCTURE - 75' FROM STAMM  
 ADDITIONAL DECK NOT TO BE BOUND EXISTING F.R.

ENTERED

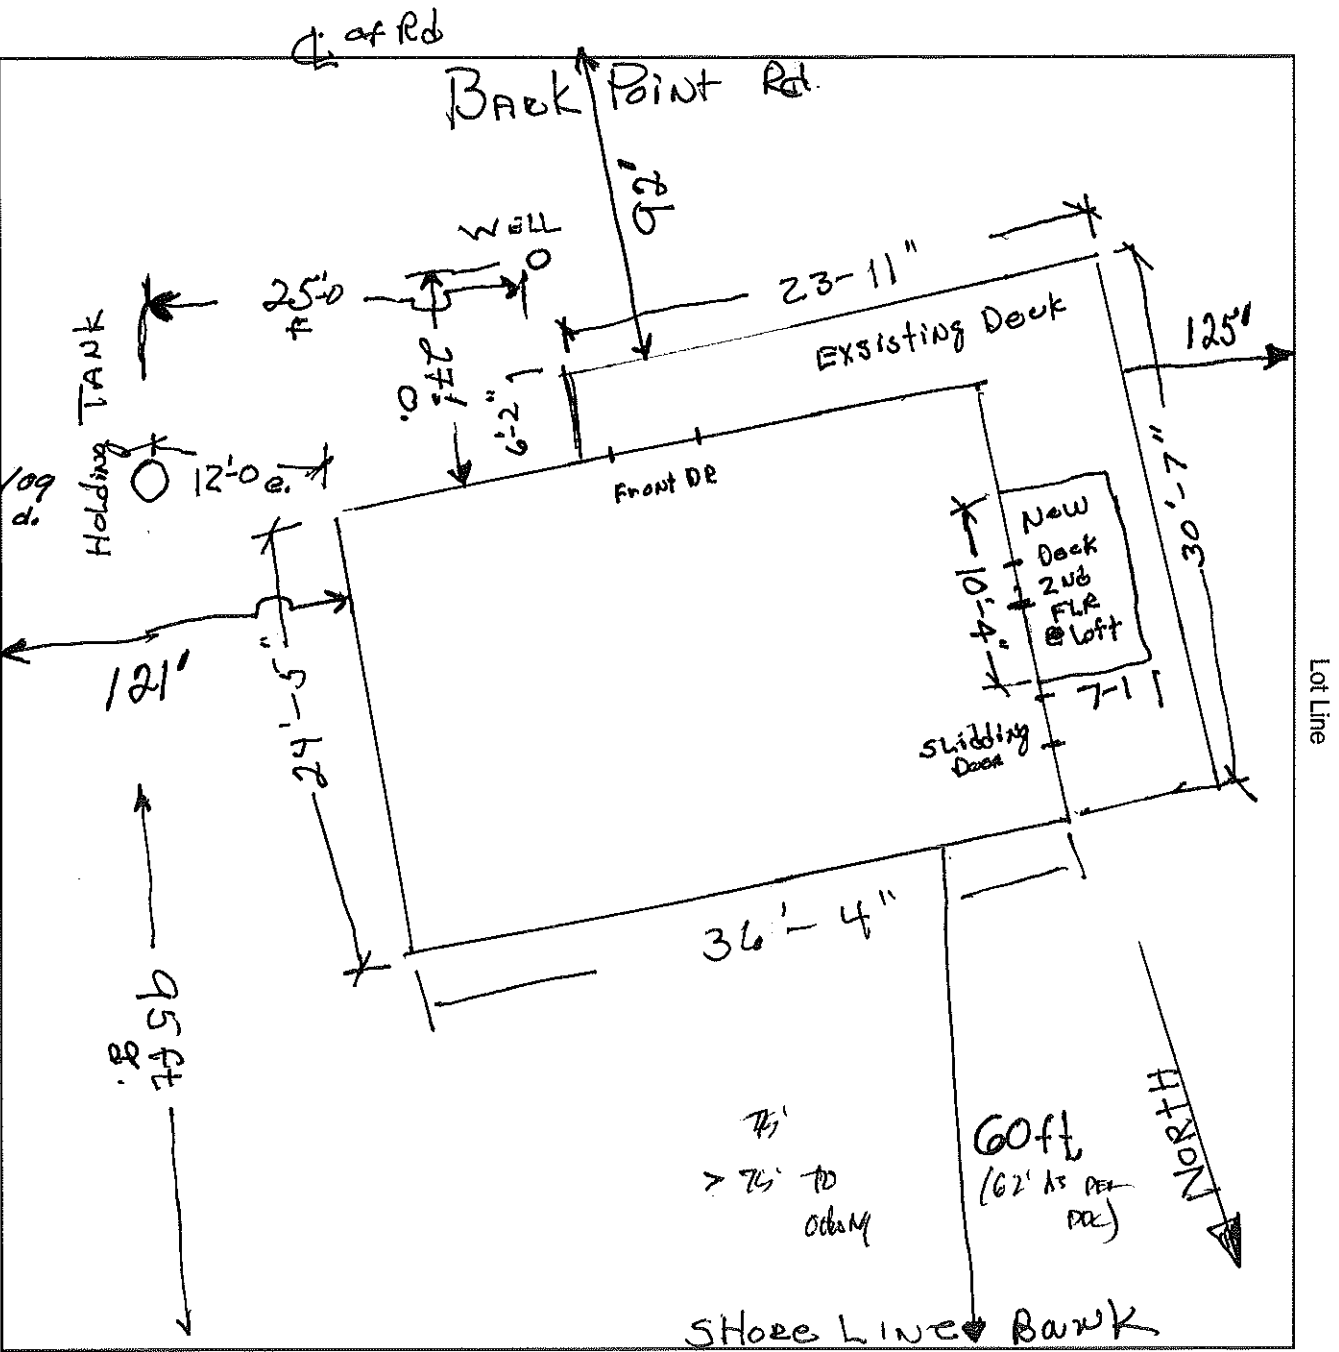

Name of Frontage Road (~~Back Point Rd~~)

1. ✓ Name the frontage road and use as a guideline, fill in the lot dimensions and indicate North (N).
2. ✓ Show the location, size and dimensions of the structure - (include any deck(s), porch or garage)
 

**IMPORTANT**  
DETAILED PLOT PLAN  
IS NECESSARY, FOLLOW  
STEPS 1-7 (a-o) COMPLETELY
3. ✓ Show the location of the well, septic tank and drain field.
4. ✓ Show the location of any lake, river, stream or pond if applicable.
5. ✓ Show the approximate location of other existing structures. *N/A NONE*
6. ✓ Show the approximate location of any wetlands or slopes over 20 percent.
 

**IMPORTANT**  
DETAILED PLOT PLAN  
IS NECESSARY, FOLLOW  
STEPS 1-7 (a-o) COMPLETELY
7. Show dimensions in feet on the following:
  - a. Building to all lot lines
  - b. Building to centerline of road
  - c. Building to lake, river, stream or pond
  - d. Septic tank to closest lot line
  - e. Septic tank to building
  - f. Septic tank to well
  - g. Septic tank to lake, river, stream or pond
  - h. Privy to closest lot line *none*
  - i. Privy to building *none*
  - j. Privy to lake, river, stream or pond *none*
  - k. Drain field to closest lot line *none*
  - l. Drain field to building *none*
  - m. Drain field to well *none*
  - n. Drain field to lake, river, stream or pond. *none*
  - o. Well to building

\*NOTICE: All Land Use Permits Expire One (1) Year From The Date Issued.

For The Construction Of New One & Two Family Dwellings: ALL Municipalities Are Required To Enforce The Uniform Dwelling Code. You Must Contact Your Town Chairman / Clerk For More Information.

The local town, village, city, state or federal agencies may also require permits.

Stake or mark proposed location(s) of new building, septic, drain field, privy, and well. Inspector will not make an inspection until location(s) are staked or marked.