

**APPLICATION FOR
RECREATIONAL VEHICLE**

Bayfield County Planning and Zoning Department
P.O. Box 58
117 East Sixth Street
Washburn, WI 54891
Phone - (715) 373-6138

R E C E I V E D
JUL 15 2011

Bayfield Co. Zoning Dept.

INSTRUCTIONS: No permits will be issued until all fees are paid.
Checks are made payable to: Bayfield County Zoning Department.
DO NOT START CONSTRUCTION UNTIL ALL PERMITS HAVE BEEN ISSUED TO APPLICANT.
Changes in plans must be approved by the Zoning Department

RUTS.00 Extension 175.00

Office Use:	
Application No.	11-0296
Date	8/25/11
Fee Paid	\$250.00 205
	7/15/11

Applicant Francine Alt-Greene & Jeff Greer Property Address _____ of RV Leafy's Road, ~~Herbster, WI~~
Mailing Address 9806 Almond Ave N
Brooklyn Park MN 55443 54844
Telephone 612 964-5549 Written Authorization Attached: Yes () No ()

Accurate Legal Description involved in this request:

Zoning District: R2RB

~~1/4~~ 1/4 of Section 34 Township 51 N. Range 07 W. Town of Clover

Gov't Lot _____ **Lot** _____ **Block** _____ **Subdivision** _____ **CSM #** _____
01-000-30000
Volume _____ **Page** _____ of Deeds **Parcel I.D. #** 04-014-2-51-07-34-1 **Acreeage** 9.44

Additional Legal Description: NE of Leafy's & Bark Bay Rd

ATTACH
Copy of Tax Statement

Is your RV in a Shoreland Zone? Yes No If Yes, Distance from Shoreline: 75' or greater < 75' to 40' less than 40'

RV: New Replacement **Vin #** 1N16TMA2161075963
Make of RV: Finsbruck **Model of RV:** T265TBS

FAILURE TO OBTAIN A PERMIT or PLACING RV ON PROPERTY WITHOUT A PERMIT WILL RESULT IN PENALTIES

APPLICANT - PLEASE COMPLETE REVERSE SIDE

For Office Use Only	
Permit Issued:	Sanitary Number <u>1451</u> Date <u>7-1-11</u>
Issuance Date <u>8/25/11</u> Permit Number <u>11-0296</u> Permit Denied (Date) _____	
Reason for Denial: _____	
Inspection Record: <u>Sanitary Certificate Passed</u>	
By <u>RAE</u> Date of Inspection <u>7-25-11</u>	
Variance (B.O.A.) # _____	
Condition: <u>RV may be placed up to 4 months from issuance date.</u> Must be removed by: <u>Nov 25 2011</u>	
Signed <u>[Signature]</u> Inspector for Issuance _____ Date of Approval <u>9-29-11</u>	
<u>State use permit required</u>	

Secretarial Staff

RAE TBA AUG 4 17, 2013



BACHAND PLUMBING & HEATING

P. O. BOX 56
WASHBURN, WISCONSIN 54891
(715) 373-2070



SCALE 1" = 50' UNLESS NOTED

SITE PLAN


LEFTYS ROAD

B1 99.56'
B2 99.86'
B3 99.56'

140'

190'

N

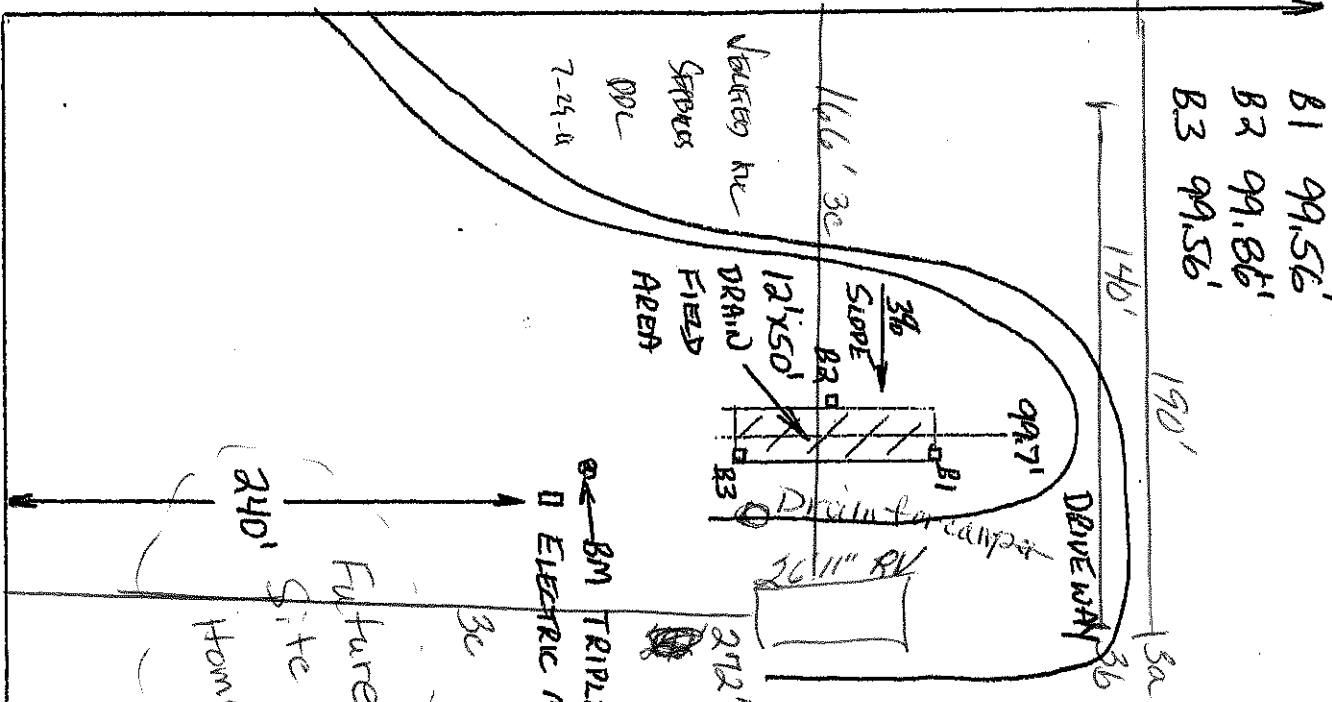

BARK BAY ROAD

FRANCIS ALAN JEFFERY

L. GREEN

SWIDENE 34-51-712

TOWN OF CLOVER

ID# 04-014-2-51-07-34-1

01-000-20000

NO WELL ON SITE

BM TRIPLE OAK NAIL AT BASE 100.0'
ELECTRIC METER

Future of Home Site
240'

660'