

SUBMIT COMPLETED ORIGINAL APPLICATION, TAX STATEMENT AND FEE TO:
 Bayfield County Zoning Department
 P.O. Box 58
 Washburn, WI 54891
 (715) 373-6138

APPLICATION FOR PERMIT
 BAYFIELD COUNTY, WISCONSIN
RECEIVED
 DEC 08 2010

Application No.: 10-0496
 Date: _____
 Zoning District: W/-
 Amount Paid: 75.-
75. ATF
12-13-10/
mfj

8

Bayfield County Zoning Dept.
ATF

INSTRUCTIONS: No permits will be issued until all fees are paid. Checks are made payable to: Bayfield County Zoning Department. DO NOT START CONSTRUCTION UNTIL ALL PERMITS HAVE BEEN ISSUED TO APPLICANT. Changes in plans must be approved by the Zoning Department.

LAND USE SANITARY PRIVY CONDITIONAL USE SPECIAL USE B.O.A. OTHER _____

Use Tax Statement for Legal Description
 Legal Description NW 1/4 of SW 1/4 of Section 8 Township 48N Range 7 West. Town of Deerp
 Gov't Lot _____ of _____ Block _____ of _____ Subdivision 8
 Volume _____ Page _____ of Deeds _____ Parcel I.D. 06-06-2-6-07-06-3 07-000-6000
 Property Owner Richard Neff et al Contractor NONE (Phone) 715-682-3521
 Address of Property 19090 CH of DEER Plumber NONE
 Telephone _____ (Home) _____ (Work) _____ Authorized Agent _____ (Phone) _____

Is your structure in a Shoreland Zone? Yes No If yes, _____
 Structure: New _____ Addition Existing _____
 Fair Market Value \$ 275.00 Square Footage 90 sq feet Existing _____
 USE: _____
 * Residence or Principal Structure (# of bedrooms) _____
 Residence sq. ft. _____
 * Residence w/deck-porch (# of bedrooms) _____
 Residence sq. ft. _____ Porch sq. ft. _____
 Deck sq. ft. _____ Deck(2) sq. ft. _____
 * Residence w/attached garage (# of bedrooms) _____
 Residence sq. ft. _____ Garage sq. ft. _____

Residential Addition / Alteration (explain) Widow way
 Residential Accessory Building (explain) _____
 Residential Accessory Building Addition (explain) _____
 Residential Other (explain) Hunting Cabin
 FAILURE TO OBTAIN A PERMIT OR STARTING CONSTRUCTION WITHOUT A PERMIT WILL RESULT IN PENALTIES
 I (we) declare that this application (including any accompanying information) has been examined by me (us) and to the best of my (our) knowledge and belief it is true, correct and complete. I (we) acknowledge that I (we) am (are) responsible for the detail and accuracy of all information I (we) am (are) providing and that it will be relied upon by Bayfield County in determining whether to issue a permit. I (we) further accept liability which may be a result of Bayfield County relying on this information I (we) am (are) providing in or with this application. I (we) consent to county officials charged with administering county ordinances to have access to the above described property at any reasonable time for the purpose of inspection.

Owner or Authorized Agent (Signature) Ronald Frasier Date _____
M. Frasier
Richard Neff
 Address to send permit _____ ATTACH _____
 * See Notice on Back

APPLICANT - PLEASE COMPLETE REVERSE SIDE
 Permit Issued: _____ State Sanitary Number _____ Date _____
 Date 12/13/10 Permit Number 10-0496 Permit Denied (Date) _____
 Reason for Denial: _____
 Inspection Record: Structural Services/conditions as built appears to meet code requirements
W. Permit may be issued By DEC Date of Inspection 12-3-10
 Mitigation Plan Required: Yes No Variance (B.O.A.) # _____
 Condition: _____

Signed _____ Inspector _____
 Date of Approval DEC 13 2010
 Rec'd for issuance 12-3-10
 Attach a Copy of Recorded Deed

Mail to: Ronald Frasier, 507 St. Clark St. Ashland, WI 54806
 Secretary of State

RECEIVED

JUN 05 2001

4653375

'01 JUL 6 AM 10 37

REGISTER OF DEEDS

REGISTER'S OFFICE/S.S.

BAYFIELD COUNTY, WIS.



BAYFIELD COUNTY CERTIFIED SURVEY - MAP NO. 1151
LOCATED IN THE NW 1/4 OF THE SW 1/4 OF SECTION 8, T. 46 N.,
R. 7 W., IN THE TOWN OF DELTA, BAYFIELD COUNTY, WISCONSIN

W 1/4 COR
2-1/2" BRASS CAPPED IRON PIPE
S 00° 31' 51" E 360.99'

SEC. 7
1" IRON PIPE

LINE	BEARING	DISTANCE
L1	N 50° 54' 06" E	25.00
L2	S 51° 08' 43" W	25.00
L3	N 51° 08' 43" E	2.20
L4	S 41° 03' 23" W	12.38
L5	N 50° 54' 06" E	10.00

CURVE	ARC	DELTA	RADIUS	CHD.	LENGTH	CHD.	BEARING
L1	101.75	3° 48' 15"	1532.50	101.73	S 40° 39' 58" E		

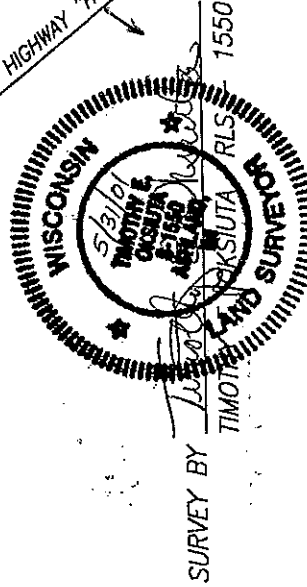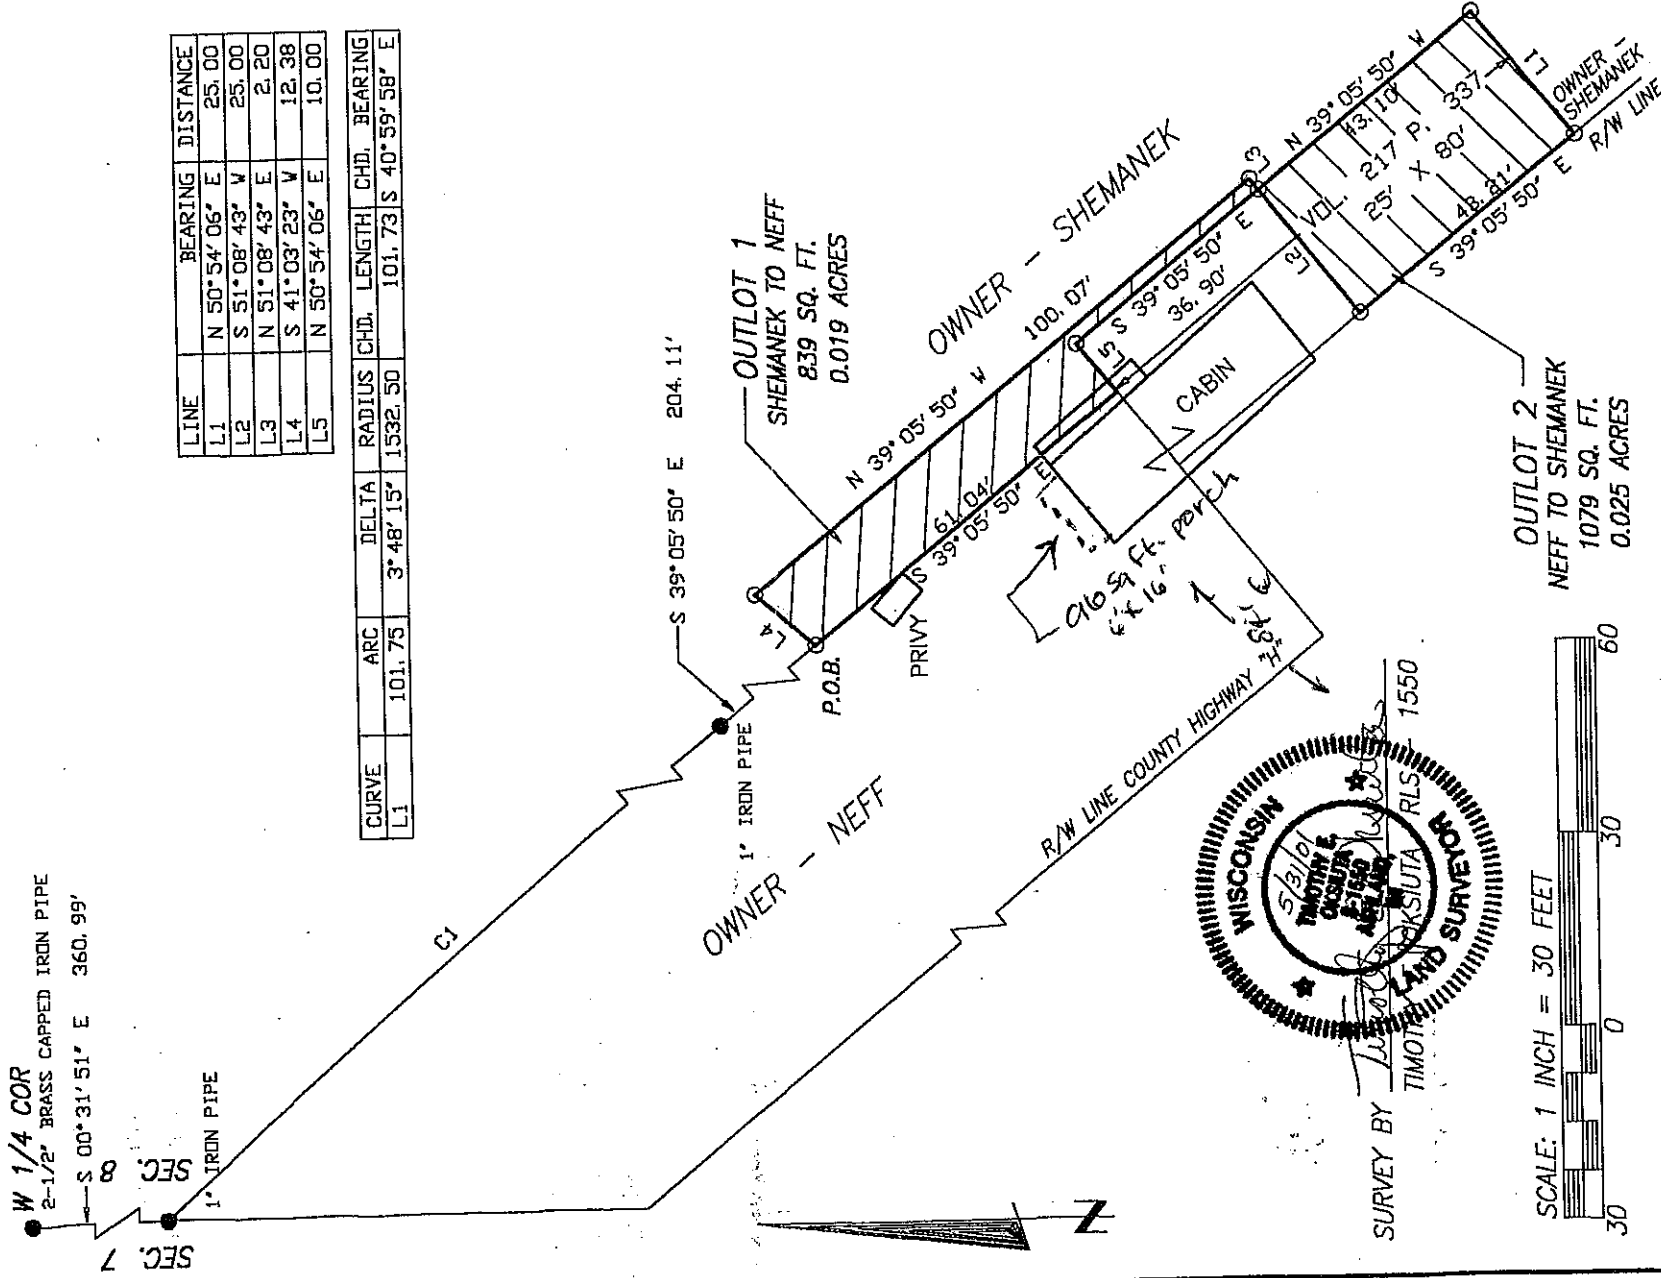

SCALE: 1 INCH = 30 FEET



LEGEND

- MONUMENT, AS NOTED, FOUND
- 1" X 24" IRON PIPE WEIGHING 1.13 LBS/LIN. FT. SET

CLIENT: RICH NEFF

JOB NO: 205/00
SCALE: 1" = 30'
DATE: 5/24/01
DRAFTED BY: JRN
DISK: 204
FILE: 205.00
NB. 310 /PG. 1
SHEET 1 OF 2

NELSON

101 W. MAIN STREET
SUITE 207
ASHLAND, WISCONSIN 54806
(715) 682-2682
FAX: (715) 682-5100
INCORPORATED 11-12-00
SURVAYING NORTHERN WISCONSIN SINCE 1867