

SUBMIT COMPLETED ORIGINAL APPLICATION, TAX STATEMENT AND FEE TO:  
 Bayfield County Zoning Department  
 P.O. Box 58  
 Washburn, WI 54891  
 (715) 373-6138

APPLICATION FOR PERMIT  
 BAYFIELD COUNTY, WISCONSIN  
**RECEIVED**

DEC 13 2009

**ATF**

Application No.: 09-0576  
 Date: \_\_\_\_\_  
 Zoning District: E-1/-  
 Amount Paid: \$157 / 12/21/09  
ATF - \$75 } mg Ente  
Ente

INSTRUCTIONS: No permits will be issued until all fees are paid. Checks are made payable to: Bayfield County Zoning Department. DO NOT START CONSTRUCTION UNTIL ALL PERMITS HAVE BEEN ISSUED TO APPLICANT. Changes in plans must be approved by the Zoning Department.

LAND USE  SANITARY  PRIVY  CONDITIONAL USE  SPECIAL USE  B.O.A.  OTHER \_\_\_\_\_

Use Tax Statement for Legal Description

Legal Description 1/4 of 1/4 of Section 14 Township 47 North, Range 09 West Town of Iron West

Gov't Lot 8 Lot \_\_\_\_\_ Block \_\_\_\_\_ Subdivision \_\_\_\_\_ CSM # \_\_\_\_\_ Acreage \_\_\_\_\_

Volume \_\_\_\_\_ Page \_\_\_\_\_ of Deeds \_\_\_\_\_ Parcel I.D. 09-024-2-41-06-17-3 05-005-50000

Property Owner Williams Lynn Contractor SELF (Phone) \_\_\_\_\_

Address of Property Iron River Wf. 54847 Plumber \_\_\_\_\_ (Phone) \_\_\_\_\_

Telephone 715 372 5128 (Home) 609 416 2836 (work) Authorized Agent \_\_\_\_\_ (Phone) \_\_\_\_\_

Is your structure in a Shoreland Zone? Yes  No  If Yes: Distance from Shoreline: greater than 75'  75' to 40'  less than 40'

Structure: New  Addition  Existing \_\_\_\_\_ Written Authorization Attached: Yes  No

Fair Market Value 3,000.00 Square Footage 250 Basement: Yes  No  Number of Stories 2

USE: Sanitary: New  Existing \_\_\_\_\_ Privy \_\_\_\_\_ City \_\_\_\_\_

\* Residence or Principal Structure (# of bedrooms) \_\_\_\_\_ Type of Septic/Sanitary System Batchelor

Residence sq. ft. \_\_\_\_\_ Mobile Home (manufactured date) \_\_\_\_\_

\* Residence w/deck-porch (# of bedrooms) \_\_\_\_\_ Commercial Principal Building \_\_\_\_\_

Residence sq. ft. \_\_\_\_\_ Porch sq. ft. \_\_\_\_\_ Commercial Principal Building Addition (explain) \_\_\_\_\_

Deck sq. ft. \_\_\_\_\_ Deck(2) sq. ft. \_\_\_\_\_ Commercial Accessory Building (explain) \_\_\_\_\_

\* Residence w/attached garage (# of bedrooms) ATF Commercial Accessory Building Addition (explain) \_\_\_\_\_

Residential Addition / Alteration (explain) open porch Commercial Other (explain) \_\_\_\_\_

Residential Accessory Building (explain) \_\_\_\_\_ External Improvements to Principal Building (explain) \_\_\_\_\_

Residential Accessory Building Addition (explain) \_\_\_\_\_ External Improvements to Accessory Building (explain) \_\_\_\_\_

Residential Other (explain) \_\_\_\_\_

FAILURE TO OBTAIN A PERMIT OF STARTING CONSTRUCTION WITHOUT A PERMIT WILL RESULT IN PENALTIES

I (we) declare that this application (including any accompanying information) has been examined by me (us) and to the best of my (our) knowledge and belief it is true, correct and complete. I (we) acknowledge that I (we) am (are) responsible for the detail and accuracy of all information I (we) am (are) providing and that it will be relied upon by Bayfield County in determining whether to issue a permit. I (we) further accept liability which may be a result of Bayfield County relying on this information I (we) am (are) providing in or with this application. I (we) consent to county officials charged with administering county ordinances to have access to the above described property at any reasonable time for the purpose of inspection.

Owner or Authorized Agent (Signature) Lynn Williams Date 12-13-09

Address to send permit 67030 Spider Lk Rd Iron River Wf. 54847 ATTACH \_\_\_\_\_

\* See Notice on Back

APPLICANT - PLEASE COMPLETE REVERSE SIDE

(If you recently purchased the property Attach a Copy of Recorded Deed)

Permit Issued: State Sanitary Number 921561 Date 7000

Date 12/21/09 Permit Number 09-0576 Permit Denied (Date) \_\_\_\_\_

Reason for Denial: \_\_\_\_\_

Inspection Record: Swimming Services/Conditions "As-Built" APPEAR TO MEET APPLICABLE CODE REQS

THIS THE LV RESULT MAY BE ISSUED BY DOC Date of Inspection 12-18-09


Mitigation Plan Required: Yes  No

Condition: \_\_\_\_\_ Variance (B.O.A.) # \_\_\_\_\_

Costs DEFERRED / MAINTAIN THE SIGNED [Signature] 12-18-09 Date of Approval

ADDITIONAL Inspector

Rec'd for Issuance

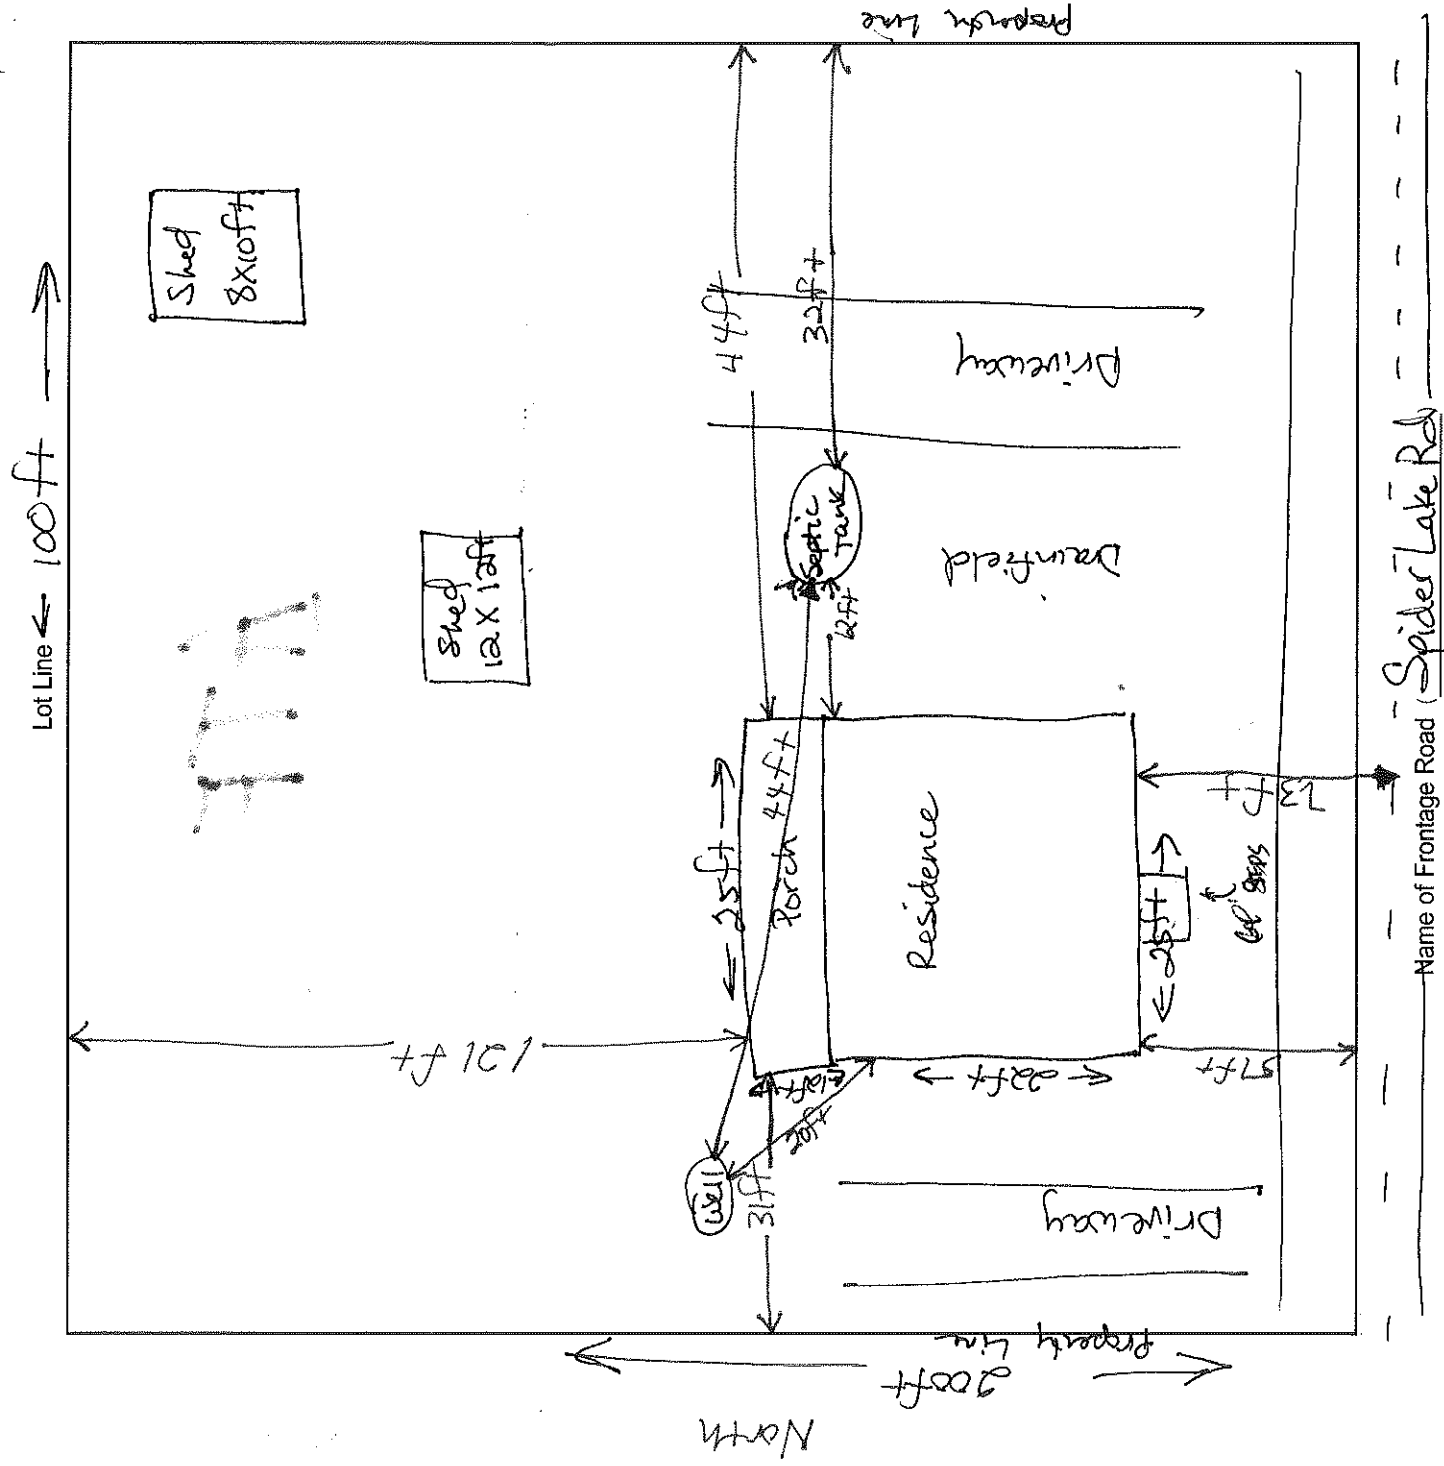

- ✓ 1. Name the frontage road and use as a guideline, fill in the lot dimensions and indicate North (N).
- ✓ 2. Show the location, size and dimensions of the structure.
- ✓ 3. Show the location, size and dimensions of attached deck(s), porch(s) or garage.
- ✓ 4. Show the location of the well, holding tank, septic tank and drain field.
- NPS 5. Show the location of any lake, river, stream or pond if applicable.
- ✓ 6. Show the location of other existing structures.
- NPS 7. Show the location of any wetlands or slopes over 20 percent.
8. Show dimensions in feet on the following:

**IMPORTANT**  
 DETAILED PLOT PLAN  
 IS NECESSARY, FOLLOW  
 STEPS 1-8 (a-o) COMPLETELY.

- |  |   |
|--|---|
| <ol style="list-style-type: none"> <li>a. Building to all lot lines</li> <li>b. Building to centerline of road</li> <li>c. Building to lake, river, stream or pond</li> <li>d. Holding tank to closest lot line</li> <li>e. Holding tank to building</li> <li>f. Holding tank to well</li> <li>g. Holding tank to lake, river, stream or pond</li> <li>h. Privy to closest lot line</li> </ol> | <ol style="list-style-type: none"> <li>i. Privy to building</li> <li>j. Privy to lake, river, stream or pond</li> <li>k. Septic Tank and Drain field to closest lot line</li> <li>l. Septic Tank and Drain field to building</li> <li>m. Septic Tank and Drain field to well</li> <li>n. Septic Tank, and Drain field to lake, river, stream or pond.</li> <li>o. Well to building</li> </ol> |
|--|---|

\*NOTICE: All Land Use Permits Expire One (1) Year From The Date Issued.

For The Construction Of New One & Two Family Dwellings: ALL Municipalities Are Required To Enforce The Uniform Dwelling Code.  
 You Must Contact Your Town Chairman / Clerk For More Information.

The local town, village, city, state or federal agencies may also require permits.

Stake or mark proposed location(s) of new building, holding tank, septic, drain field, privy, and well. Inspector will not make an inspection until location(s) are staked or marked.