

SUBMIT COMPLETED ORIGINAL APPLICATION, TAX STATEMENT AND FEE TO:

Bayfield County Zoning Department
P.O. Box 58
Washburn, WI 54891
(715) 373-6138

APPLICATION FOR PERMIT
BAYFIELD COUNTY, WISCONSIN

RECEIVED

DEC 22 2010

BY:

INSTRUCTIONS: No permits will be issued until all fees are paid. Checks are made payable to: Bayfield County Zoning Department. DO NOT START CONSTRUCTION UNTIL ALL PERMITS HAVE BEEN ISSUED TO APPLICANT. Changes in plans must be approved by the Zoning Department.

LAND USE SANITARY PRIVY CONDITIONAL USE SPECIAL USE B.O.A. OTHER _____

Use Tax Statement for Legal Description

Legal Description SJ 1/4 of SJ 1/4 of Section 33 Township 47 North, Range 8 West, Town of Iron River

Gov't Lot _____ Lot _____ Block _____ Subdivision _____ CSM # _____ Acreage 30

Volume _____ Page _____ Parcel I.D. PIN 04-024-2-47-08-33-3 03-000-1200

Property Owner RICHARDA WITALA Contractor OWNER (Phone) 218 819 3042

Address of Property 6500 Iron River Wis Plumber POLKOSKI

Authorized Agent _____ (Phone) _____

Telephone 218 819 3042 (Home) 218 819 1937 (Work) 218-16-172

Is your structure in a Shoreland Zone? Yes No If yes, _____

Structure: New YES Addition _____ Existing _____

Fair Market Value 15,000 +/- ? Square Footage 864

USE: 5000 sq. ft.

* Residence or Principal Structure (# of bedrooms) ONE

Residence sq. ft. 864

* Residence w/deck-porch (# of bedrooms) ONE

Residence sq. ft. 864

Deck sq. ft. _____

* Residence w/attached garage (# of bedrooms) _____

Residence sq. ft. 864

Garage sq. ft. 770-864

Residential Addition / Alteration (explain) _____

Residential Accessory Building (explain) SEWER HOUSE 112 SQ FT

Residential Accessory Building Addition (explain) _____

Residential Other (explain) _____

Commercial Principal Building _____

Commercial Principal Building Addition (explain) _____

Commercial Accessory Building (explain) _____

Commercial Accessory Building Addition (explain) _____

Commercial Other (explain) _____

Special/Conditional Use (explain) _____

External Improvements to Principal Building (explain) _____

External Improvements to Accessory Building (explain) _____

Owner or Authorized Agent (Signature) Richard a Witala Date 6/22/10

Address to send permit 1305 HWY 45 SCANLON MN 55730

* See Notice on Back

APPLICANT — PLEASE COMPLETE REVERSE SIDE

Permit issued: _____ State Sanitary Number 08-565 Date 6-10-08

Date 1/12/11 Permit Number 11-0007 Permit Denied (Date) _____

Reason for Denial: SEWER SYSTEM TRENCH INSTALLED THAT IS DISTURBED TO

Inspection Record: INTERVIEW CONDUCTED & AS BUILT STRUCTURE SETBACKS & CONDITIONS APPEAR TO MEET CODE REQS

& PERMIT MAY BE ISSUED RE BY DDC Date of Inspection 1-4-11

Mitigation Plan Required: Yes No (fee) _____ Variance (B.O.A.) # _____

Condition: A ULTIMATE AS-BUILT CODE PERMIT FROM THE LOCALITY CONTRACTED FOR INSPECTION REQS

MUST BE OBTAINED PRIOR TO THE START OF CONSTRUCTION.


Signed [Signature] Inspector _____

Date of Approval 1-1-11

FAILURE TO OBTAIN A PERMIT OR STARTING CONSTRUCTION WITHOUT A PERMIT WILL RESULT IN PENALTIES. I (we) declare that this application (including any accompanying information) has been examined by me (us) and to the best of my (our) knowledge and belief it is true, correct and complete. I (we) acknowledge that I (we) am (are) responsible for the detail and accuracy of all information I (we) am (are) providing and that it will be relied upon by Bayfield County in determining whether to issue a permit. I (we) further accept liability which may be a result of Bayfield County relying on this information I (we) am (are) providing in or with this application. I (we) consent to county officials charged with administering county ordinances to have access to the above described property at any reasonable time for the purpose of inspection.

Copy of Tax Statement or Attach a Copy of Recorded Deed

ATTAACH

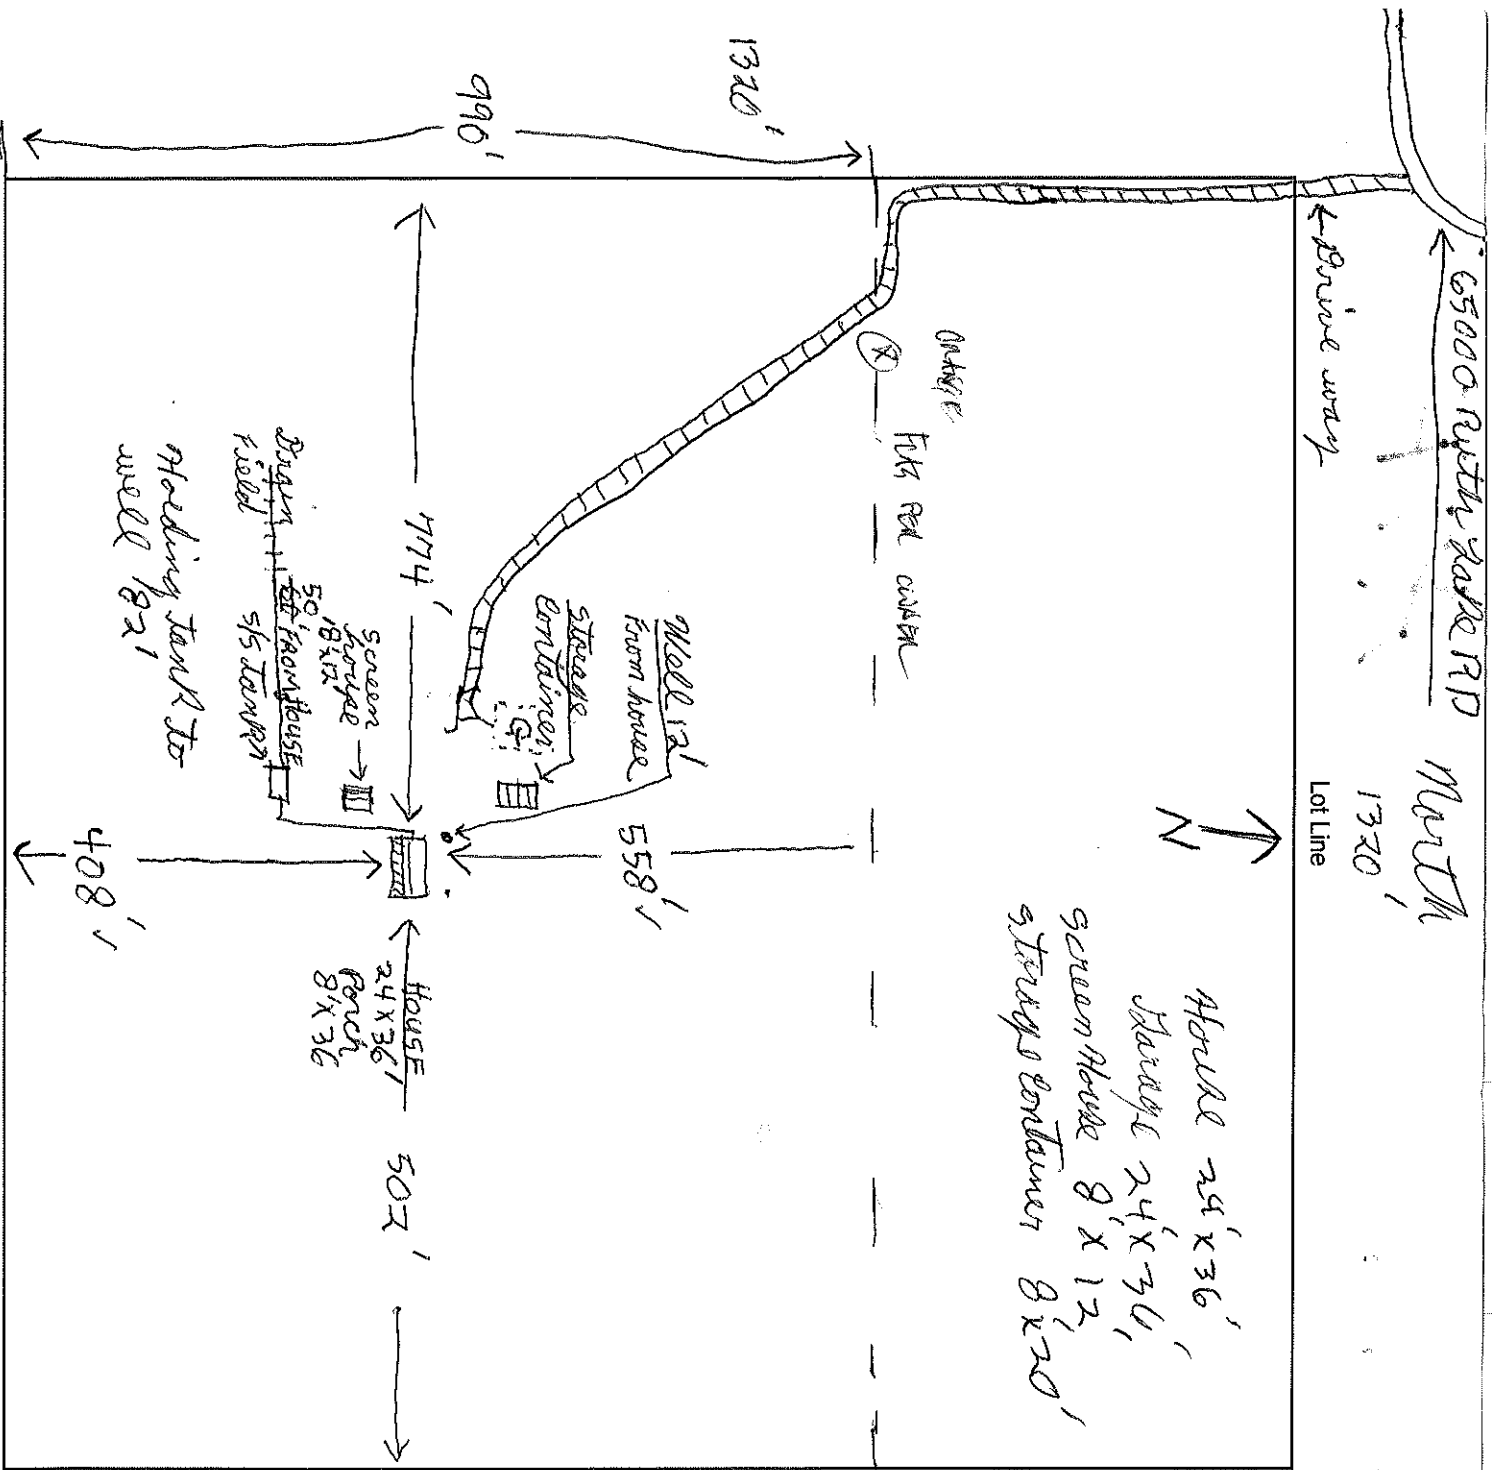

PH-11 animal waste structure Accessory Basin (N) 65000
 Name of Frontage Road (Ruth Lake Rd)

1. Name the frontage road and use as a guideline, fill in the lot dimensions and indicate North (N).
2. Show the location, size and dimensions of the structure.
3. Show the location, size and dimensions of attached deck(s), porch(s) or garage.
4. Show the location of the well, holding tank, septic tank and drain field.
5. Show the location of any lake, river, stream or pond if applicable.
6. Show the location of other existing structures.
7. Show the location of any wetlands or slopes over 20 percent.
8. Show dimensions in feet on the following:
 - a. Building to all lot lines ✓
 - b. Building to centerline of road 1 mile
 - c. Building to lake, river, stream or pond
 - d. Holding tank to closest lot line
 - e. Holding tank to building
 - f. Holding tank to well
 - g. Holding tank to lake, river, stream or pond
 - h. Privy to closest lot line
 - i. Privy to building
 - j. Privy to lake, river, stream or pond
 - k. Septic Tank and Drain field to closest lot line
 - l. Septic Tank and Drain field to building
 - m. Septic Tank and Drain field to well
 - n. Septic Tank, and Drain field to lake, river, stream or pond.
 - o. Well to building

IMPORTANT
 DETAILED PLOT PLAN
 IS NECESSARY, FOLLOW
 STEPS 1-8 (a-o) COMPLETELY.

*NOTICE: All Land Use Permits Expire One (1) Year From The Date Issued.

For The Construction Of New One & Two Family Dwellings: ALL Municipalities Are Required To Enforce The Uniform Dwelling Code.
 You Must Contact Your Town Chairman / Clerk For More Information.

The local town, village, city, state or federal agencies may also require permits.

Stake or mark proposed location(s) of new building, holding tank, septic, drain field, privy, and well. Inspector will not make an inspection until location(s) are staked or marked.