

ATF



SUBMIT COMPLETED ORIGINAL APPLICATION, TAX STATEMENT AND FEE TO:

Bayfield County Zoning Department
 P.O. Box 58
 Washburn, WI 54891
 (715) 373-6138

APPLICATION FOR PERMIT
 BAYFIELD COUNTY, WISCONSIN

RECEIVED
 MAY 15 2009

Application No.: 09-0215
 Date: _____
 Zoning District: A-1-
 Amount Paid: 75 5/19/09

ATF-75 6/12 mgg

Bayfield Co. Zoning Dept.
 INSTRUCTIONS: No permits will be issued until all fees are paid.
 Checks are made payable to: Bayfield County Zoning Department.
 DO NOT START CONSTRUCTION UNTIL ALL PERMITS HAVE BEEN ISSUED TO APPLICANT.
 Changes in plans must be approved by the Zoning Department.

LAND USE SANITARY PRIVY CONDITIONAL USE SPECIAL USE B.O.A. OTHER _____

Use Tax Statement for Legal Description

Legal Description NW 1/4 of NE 1/4 of Section 34 Township 48 North, Range 9 West, Town of Oulu
 Gov't Lot _____ Block _____ Subdivision _____ CSM # _____ Acreage 40
 Volume 759 Page 141 of Deeds Parcel I.D. 38-1076-03 01-036-2-48-9A-01-000-10000

Property Owner: JAMES R. STUCK Contractor NORTHWARD BUILDINGS
 Address of Property: 4525 EAST VIEW RD. Authorized Agent: RICHARD GRUKA (Phone) 715-395-5705

1 ROD RIVER, WI 54847
 Telephone 715-372-6756 (Home) 414-801-3926 (Work)

Is your structure in a Shoreland Zone? Yes No if yes.

Structure: New Addition Existing _____
 Fair Market Value 20,000 Square Footage 36x54'
USE: 1944 I

- * Residence or Principal Structure (# of bedrooms) _____
- Residence sq. ft. _____
- * Residence w/deck-porch (# of bedrooms) _____
- Residence sq. ft. _____ Porch sq. ft. _____
- Deck sq. ft. _____ Deck(2) sq. ft. _____
- * Residence w/attached garage (# of bedrooms) _____
- Residence sq. ft. _____ Garage sq. ft. _____
- Residential Addition / Alteration (explain) _____
- Residential Accessory Building (explain) POKE BUILDING
- Residential Accessory Building Addition (explain) _____
- Residential Other (explain) _____

FAILURE TO OBTAIN A PERMIT OF STARTING CONSTRUCTION WITHOUT A PERMIT WILL RESULT IN PENALTIES
 I (we) declare that this application (including any accompanying information) has been examined by me (us) and to the best of my (our) knowledge and belief it is true, correct and complete. I (we) acknowledge that I (we) am (are) responsible for the detail and accuracy of all information I (we) am (are) providing and that it will be relied upon by Bayfield County in determining whether to issue a permit. I (we) further accept liability which may be a result of Bayfield County relying on this information I (we) am (are) providing in or with this application. I (we) consent to county officials charged with administering county ordinances to have access to the above described property at any reasonable time for the purpose of inspection.

Owner or Authorized Agent (Signature) James R. Stuck Date 5-15-09


Address to send permit _____ ATTACH
 Copy of Tax Statement or
 (If you recently purchased the property
 Attach a Copy of Recorded Deed)

* See Notice on Back APPLICANT - PLEASE COMPLETE REVERSE SIDE

Permit Issued: State Sanitary Number _____ Date _____
 Date 6/12/09 Permit Number 09-0215 Permit Denied (Date) _____
 Reason for Denial: _____
 Inspection Record: STRUCTURAL SERVICES/CADRENS AS-BUILT ATTACH TO BE ONE COMPLAINT P.V.O. BECAUSE MAY BE ISSUED. By DDC Date of Inspection 6-5-09
 Mitigation Plan Required: Yes No Variance (B.O.A.) # _____
 Condition: _____
 Signed James R. Stuck Inspector Date of Approval 6-5-09
 Rec'd for Issuance
00-0345

State of Wisconsin 6-10-09 the days indicated shall be set - ATF JUN 12, 2009
 Secretarial Staff

Lot Line

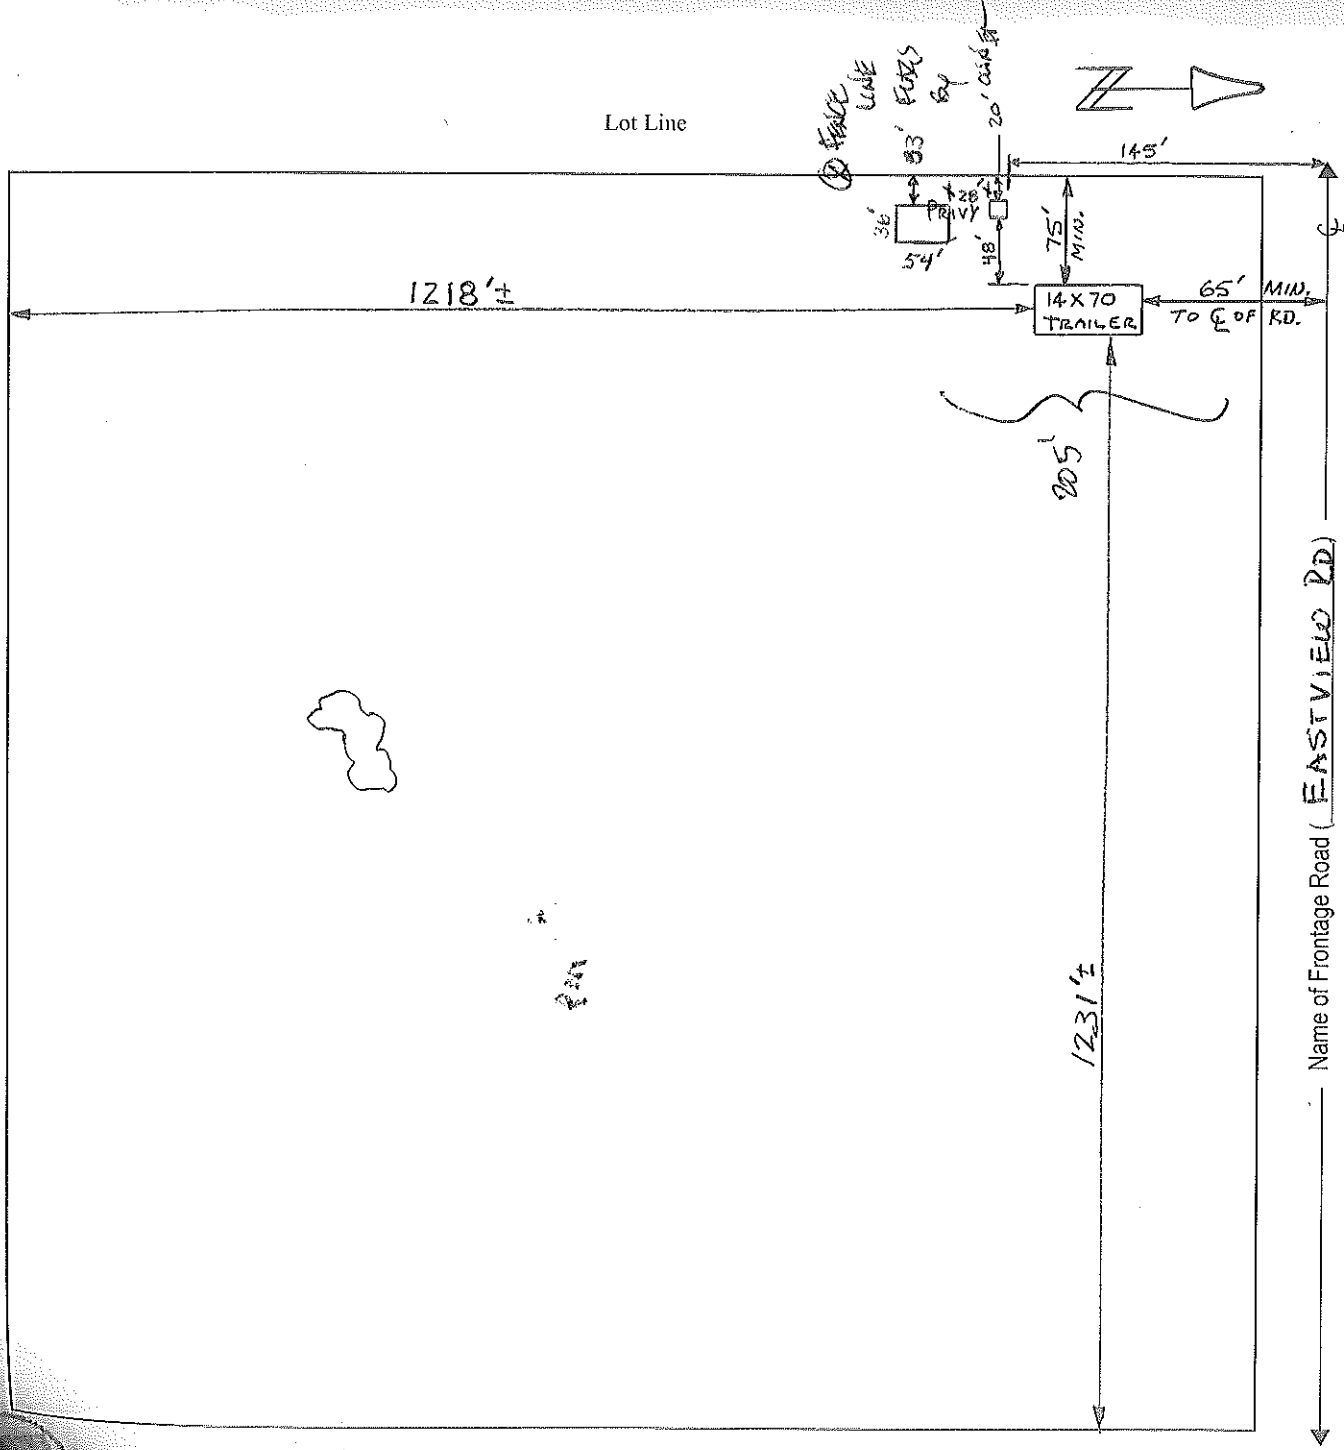

Lot Line

1. Name the frontage road and use as a guideline, fill in the lot dimensions and indicate North (N).

2. Show the approximate location and size of the building.

3. Show the location of the well, septic tank and drain field.

4. Show the location of any lake, river, stream or pond if applicable.

5. Show the approximate location of other existing structures.

6. Show the approximate location of any wetlands or slopes over 20 percent.

7. Show dimensions in feet on the following:

- a. Building to all lot lines
- b. Building to centerline of road
- c. Building to lake, river, stream or pond
- d. Septic tank to closest lot line
- e. Septic tank to building
- f. Septic tank to well
- g. Septic tank to lake, river, stream or pond
- h. Privy to closest lot line

- i. Privy to building
- j. Privy to lake, river, stream or pond
- k. Drain field to closest lot line
- l. Drain field to building
- m. Drain field to well
- n. Drain field to lake, river, stream or pond
- o. Well to building

IMPORTANT
DETAILED PLOT PLAN
IS NECESSARY, FOLLOW
STEPS 1-7 COMPLETELY.

*NOTICE: The local town, village, city, state or federal agencies may also require permits.

Stake or mark proposed location(s) of new building, septic, drain field, privy, and well. Inspector will not make an inspection until location(s) are staked or marked.