#1979

Gov. Lot 2 Sec ~~8~~ 5-43-7

"AS BUILT" MAP OF

LAKE OWEN VILLAS

LOCATED IN
GOV'T. LOT 2, SEC. 5-T43N-R7W, TOWN OF CABLE,
BAYFIELD COUNTY, WISCONSIN.

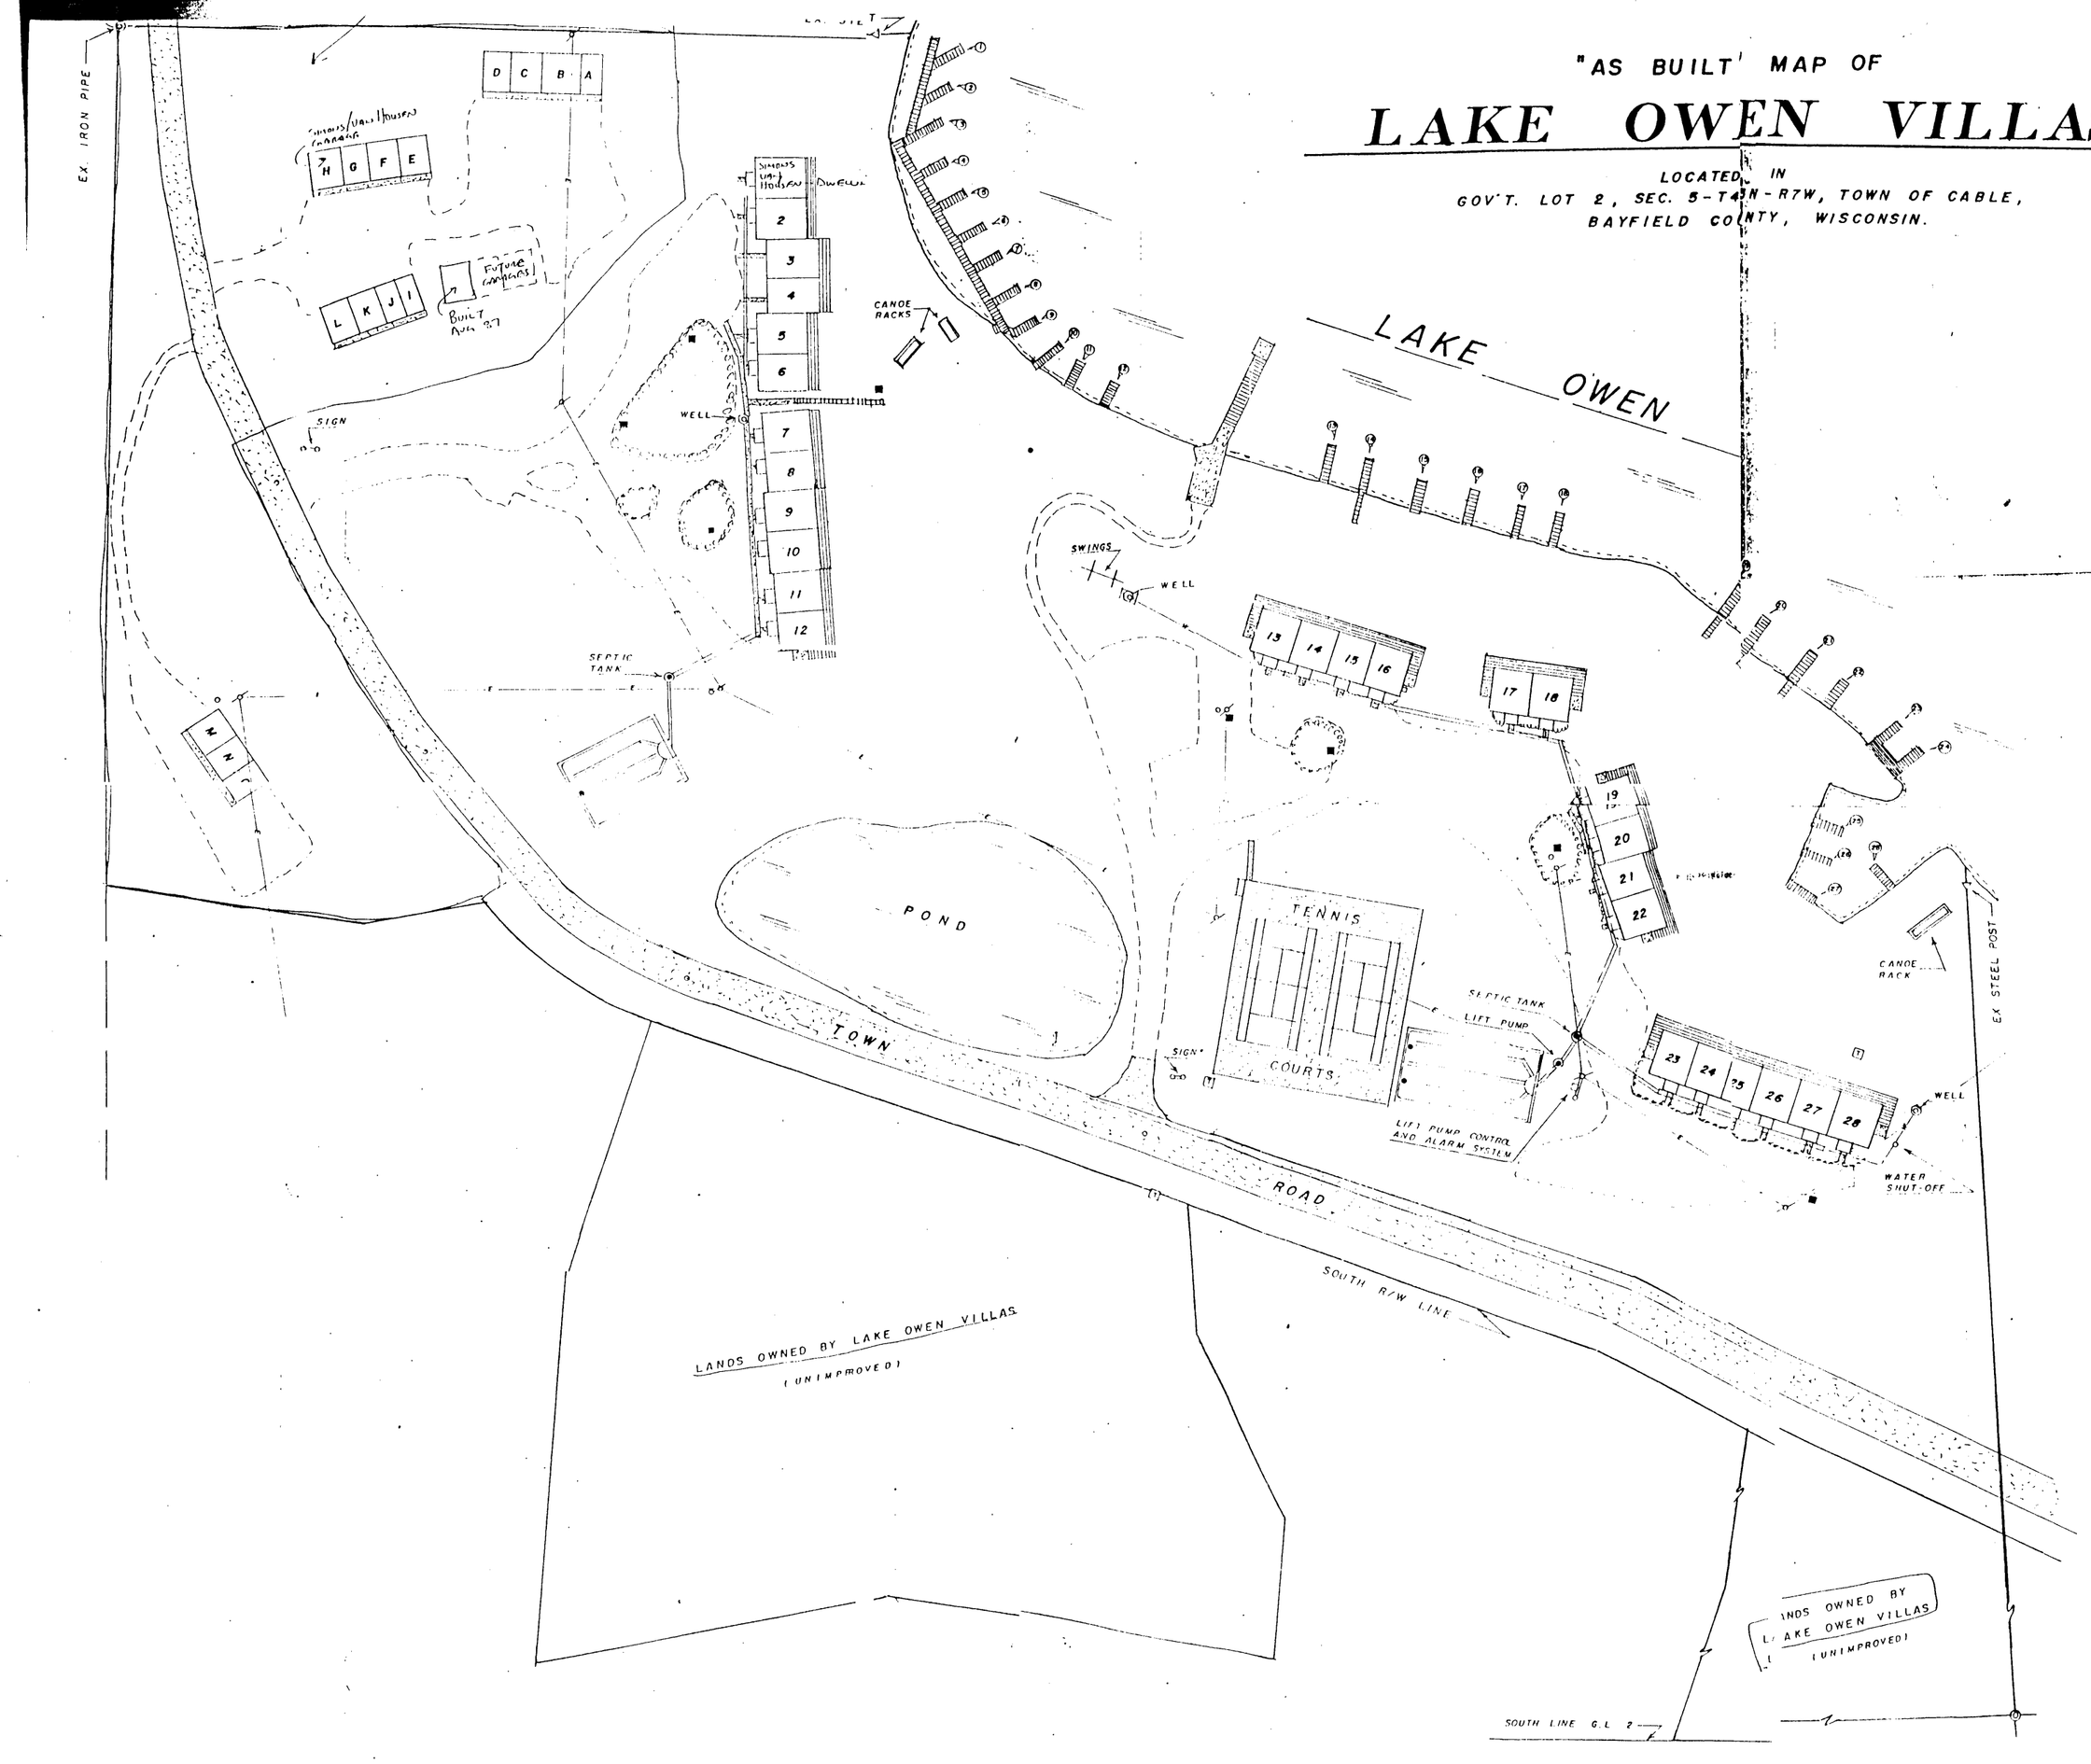

SCALE - 1" = 50'

LEGEND

- ⊘ = POWER POLE —E—
- • = SEWER VENT
- ⊙ = SEWER MANHOLE
- ⓦ = WELLS — W —
- [T] = UNDER GROUND TELEPHONE
- ■ = SECURITY LIGHTS

PREPARED FOR:

LAKE OWEN VILLAS
HOMEOWNER'S ASSOCIATION
HENRY MESCHIEVITZ - AGENT
R.R. 2, BOX 28
CABLE, WIS. 54821

PREPARED BY:

DUANE A. MARTEN
VACATIONLAND SURVEYOR'S, INC.
STAR ROUTE, BOX 5895
SOLON SPRINGS, WIS. 54873

DATED: 18 FEB. 1985

Duane A. Marten

"596"